

Our Ref: Haywards Heath/PCP053/WO/JL
Tel: 01634 661556
Email: planning@harlequin-group.com

The Planning Officer
Mid Sussex District Council
Oaklands
Oaklands Road
Haywards Heath
West Sussex
RH16 1SS



16th February 2012

Dear Sir/Madam,

NOTIFICATION OF THE SUBMISSION OF PRIOR APPROVAL APPLICATION FOR THE INSTALLATION OF 1x OPENREACH BROADBAND CABINET WITHIN THE PUBLIC HIGHWAY.

PART 24 OF THE TOWN AND COUNTRY PLANNING (GENERAL PERMITTED DEVELOPMENT ORDER) (AS AMENDED) 1995 AND ALSO REGULATION 6 OF THE ELECTRONIC COMMUNICATIONS CODE (CONDITIONS AND REGULATIONS) 2003

Please find enclosed Prior Approval application made under the legislation detailed above. Detailed below is the number of the PCP where the application has been submitted.

For ease of validation a copy of the application has been included on a CD-Rom and has been enclosed with this letter. A cheque for the figure of £335.00 pounds is enclosed to cover the fee for the 01 (one) site detailed below.

PCP053 Lewes Road, OPP Broad Oaks, Lewes Road, Haywards Heath, RH17 7SP, 534556 123138

Attached are details pursuant to each of the proposed cabinets. I have included a location plan, a photomontage and a line drawing. Please note that Openreach refers to each site with a PCP reference. As such the locations above relate to the PCP numbered below on the site details. Please could you always correspond using the PCP number as it will greatly assist us in identifying the correct cabinet.

Should you have any queries or concerns arising from this matter please do not hesitate to contact me.


Yours faithfully,

PP 

William Osborne MRTPI
Harlequin Group


The Harlequin Group • Innovation Centre • Maidstone Road • Chatham • Kent ME5 9FD
T: +44 (0)1634 683635 F: +44 (0)1634 661550 E: reception@harlequin-group.com

Huawei 96
Cabinet

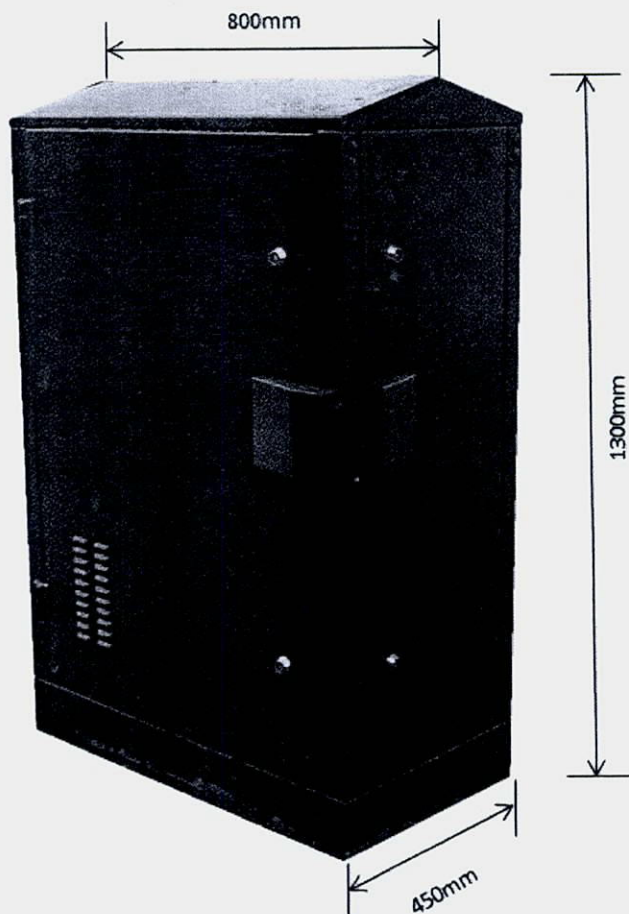

MID SUSSEX DC
17 FEB 2012
ENVIRONMENT DIVISION

PCP053 Lewes Road, OPP Broad Oaks, Lewes Road, Haywards Heath, RH17 7SP, 534556 123138

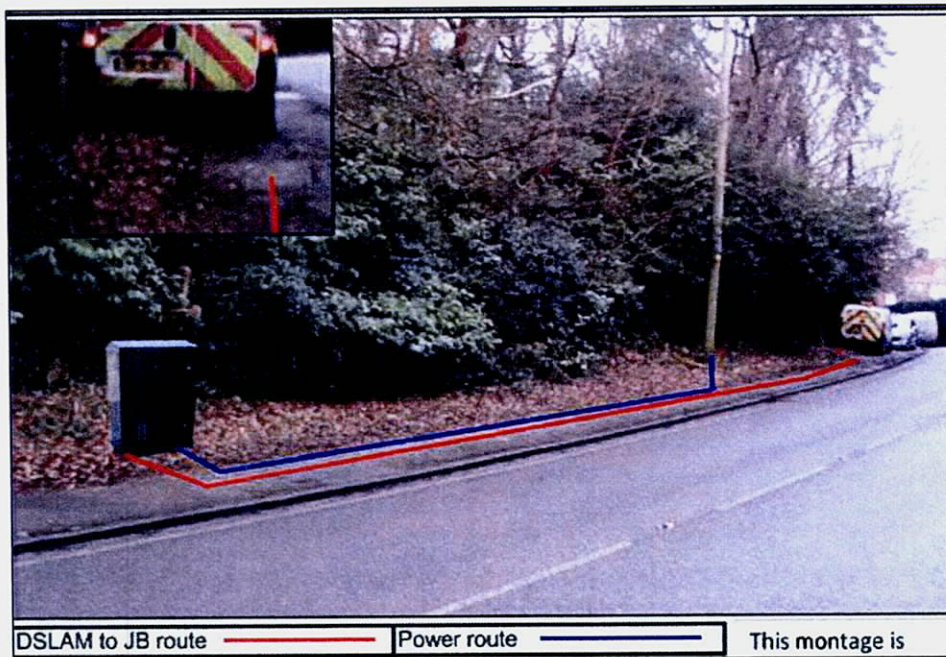

MID SUSSEX DC
17 FEB 2012

DSLAM CABINET LOCATION:

Lewes Road
OPP Broad Oaks, Lewes Road
Haywards Heath
RH17 7SP
534556 123138


Measurements

PCP to DSLAM: **34.7** Metres
DSLAM to Junction
Box: **35.8** Metres
DSLAM Power
Excavation to LV: **22.8** Metres
Pavement Width @
DSLAM: **1.8** Metres

As Laid
Date:
Drawn By:

Comments:

Line Drawing

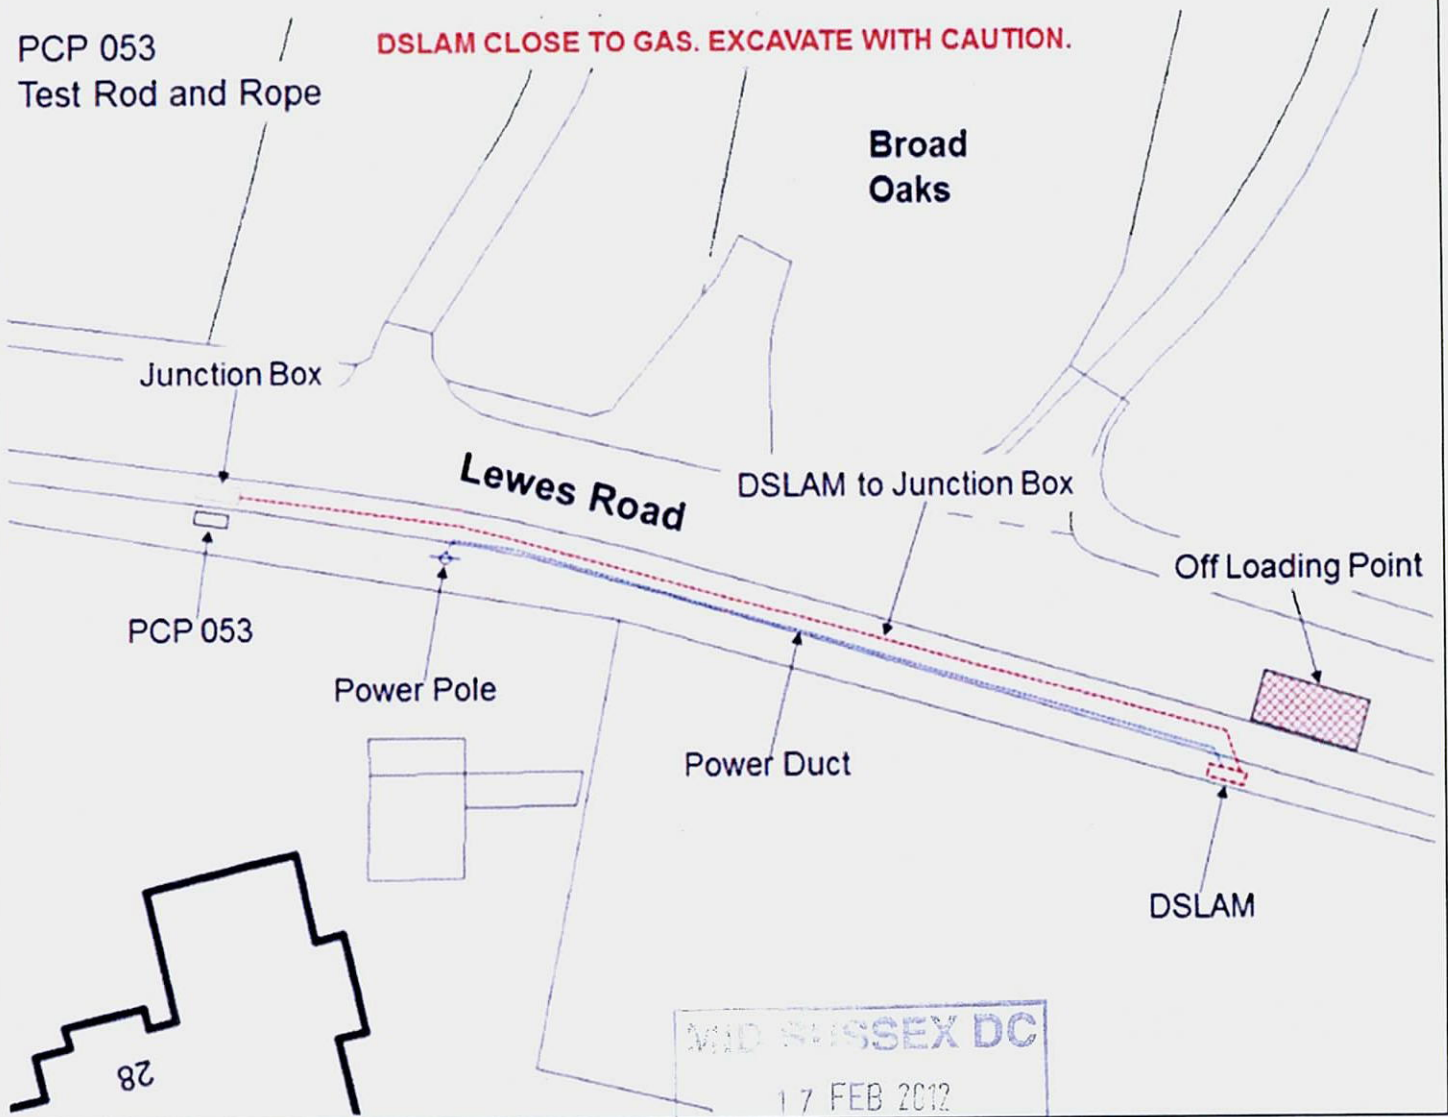

MID SUSSEX DC
17 FEB 2012
ENVIRONMENT DIVISION

Our ref: Haywards Heath/PCP053/Openreach/WO/JL
Your ref:
Direct Dial: 01634 661556
Email: planning@harlequin-group.com

Norman Perryman
Highways Department
West Sussex County Council
The Grange
Tower Street
Chichester
West Sussex
PO19 1RG

16th February 2012


Dear Sir/Madam,

**NOTIFICATION OF THE SUBMISSION OF PRIOR APPROVAL APPLICATION
FOR THE INSTALLATION OF 1X OPENREACH BROADBAND CABINET WITHIN
THE PUBLIC HIGHWAY.**

Please find enclosed notification of Openreach cabinet location where applications have been submitted to the Local Planning Authority. The notifications are made under Part 24 of the GPDO (1995) (As Amended) and Regulation 6 of the Electronic Communications Code 2003.

As the proposal is within the public highway notification is required to be sent to the land owner.

Yours faithfully,

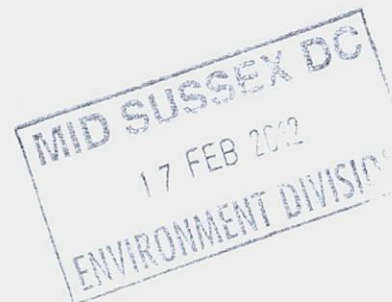

William Osborne MRTPI
Harlequin Group

The Harlequin Group · Innovation Centre · Maidstone Road · Chatham · Kent ME5 9FD
T: +44 (0)1634 683635 F: +44 (0)1634 661550 E: reception@harlequin-group.com

Developer's notice as required under the Part 24 of the General Permitted Development Order (1995) (As Amended) and Regulation 5/6 of the Electronic Communications Code 2003

Proposed Development at:

PCP053 Lewes Road, OPP Broad Oaks, Lewes Road, Haywards Heath, RH17 7SP, 534556 123138

I give notice that Harlequin Group on behalf of Openreach will be applying to Mid Sussex District Council under paragraph (4) (b) of Part 24 of Schedule 2 of the Part 24 of the General Permitted Development Order (1995) (As Amended) and regulation 6 of the Electronic Communications Code (Conditions and Regulations) 2003 for its determination as to whether the prior approval of the authority will be required to the siting and appearance of a DSLAM telecommunications cabinet located at the above address.

The application and accompanying plans may be available for public inspection at the offices of the above Authority at:- Mid Sussex District Council, Oaklands, Oaklands Road, Haywards Heath, West Sussex, RH16 1SS, during usual office hours.

Any Individual and organisation wishing to make representation about the siting and appearance of the proposed development may do so in writing to the Local Planning Authority at the address above (Please quote site address given above). Any representations must be received no later than 1st March 2012

Signed

On behalf of Openreach

Dated 16.2.12



Application for Prior Approval

1. Site Details

PCP :	053	
Exchange:	Haywards Heath	
NGR:	E 534556	N 123138
Site Address:	Lewes Road, OPP Broad Oaks, Lewes Road, Haywards Heath, RH17 7SP	

2. Planning Legislation


a. This is an application for prior approval made under Part 24 of THE TOWN AND COUNTRY PLANNING (GENERAL PERMITTED DEVELOPMENT ORDER) (AS AMENDED) 1995 and also Regulation 6 of THE ELECTRONIC COMMUNICATIONS CODE (CONDITIONS AND REGULATIONS) 2003
b. Where electronic communications equipment is installed by a Code Systems Operator within Article 1/5 land, that being a conservation area, SSSI, AONB, World Heritage Site, an application for prior approval is required to be made to the Local Planning Authority.
c. Included in this application are details pursuant to the proposed development, a site layout plan, a location plan, a photomontage and details of the dimensions of the proposed communications equipment.
d. Consideration has been given to the siting, design and visual impact of the proposed equipment cabinet and prior consultation has been carried out with the appropriate Local Planning Authority.

3. Pre-application consultation with the authority responsible for planning

Date of pre-application contact:	3.6.11
Name of contact:	Michael Parker
Summary outcome of consultation:	

4. Developer's Notice

Copy of Developer's Notice enclosed	<u>Yes</u>	No
Date served	16.2.12	

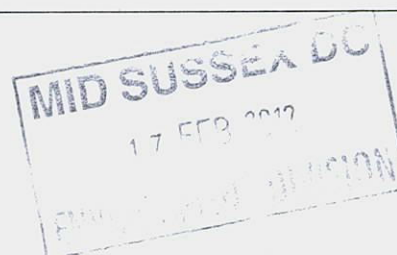

5. Proposed Development

The proposed site

The site has been chosen so that it presents the least visually obtrusive location as far as is practicable. Every effort has been made to locate the cabinet so as not to impact upon the surrounding environment.

Consideration has been given to sight lines entering and exiting side roads, driveways and junctions. Consideration has been given to the width of the pavement and to provide ease of access for pedestrians. A minimum of 1.2m is allowed but wherever possible the greatest amount of available space is chosen. Where this may impact upon underground cabling, gas mains, additional telecommunications ducting and cabling or footings of adjacent buildings, every effort has been made to ensure that the location of the cabinet does not impact upon the use of the highway.

The cabinet is usually sited at the back of the footpath in order that it is not struck by vehicles. However, in certain circumstances it is unavoidable that the cabinet is located against the kerb; either because of underground services or because of adjacent trees, frontages to residential properties, or requests from the Highways department require it to be so.

The cabinet is usually located so that the ducting to the existing Openreach spine network can be made and that power is more easily connected to. Because of these reasons at times the cabinet may be sited a distance away from the existing green Openreach cabinet (the PCP) or at times on the opposite side of the road from the existing PCP.

The location of the DSLAM cabinet must also take into consideration the safety of neighbouring residents and properties. As such DSLAM cabinets are not located adjacent to low walls or fences where access could more easily be granted to that property. Where there is an existing cabinet or where there is an existing ease of access to that property, then consideration has been made as to the optimum location and the impact upon the security of the adjacent property.

At times it may well require the DSLAM cabinet to be located adjacent to low walls or fences. However, every effort is made so that consideration is given to the visual impact of the surrounding environment and the safety of road users and local residents.

Enclosed is a plan indicating the location of the site and also a line drawing and a photomontage indicating the siting of the proposed cabinet.

6. Equipment Proposed

Equipment Proposed:

Description

The proposed cabinet includes 1x DSLAM green telecommunications cabinet located on a concrete plinth. Ducting is placed within the footpath or verge to an existing Openreach junction box and also ducting to the nearest low voltage power supply. The DSLAM cabinet is connected to both the existing copper telecoms spine and also the new fibre optic cable spine set within the existing Openreach ducting.

Equipment Housing

Length	0.80metres
Width	0.45metres
Height	1.3metres
Materials	Steel

7. Design and Access

Reasons for choice of design

The proposed development is for a 1.3m high green telecommunications cabinet (DSLAM). The cabinet provides a conversion from fibre optic cable to copper cable and then feeds the signal into the wider telephone network through the existing green Openreach cabinets (PCP). The new cabinet (DSLAM) has to be located close to the existing green Openreach cabinet (PCP) in order to reduce the amount of copper cabling within the system. The advantage of this Super Fast Broadband service is that it provides as much fibre optic cabling within the system to attain the speeds required.

Being a single telecommunications cabinet there is no public access to the application site. The installation has been designed and installed so as not to impact upon the use of the footway to either pedestrians or wheelchair users. Inside the cabinet electronic equipment provides the conversion from fibre optic to copper. Included within the cabinet is effectively a mini exchange providing the switching for the equipment and also a small cooling system. The cooling fans are rated at 40dB during daytime and 35dB at night time. The fans will only function during periods of hot weather and it has been assessed that the noise emitted from these fans is equivalent to a standard fridge compressor at 0.5m distance.

8. Additional relevant information


The proposed DSLAM Cabinet installation forms a wider part of the government's Digital Britain project. The cabinet will provide Super Fast Broadband connectivity to the majority of the population boosting not only an individual's use of the internet and thus the wider world but also boost the local economy and benefit a wide range of SMEs.

The proposed cabinet provides the surrounding properties that are currently connected to the telephone system by the existing PCP cabinet with a connection to the fibre optic cable spine and in that process new fibre optic cabling is currently being installed throughout the country. Although the DSLAM cabinet is specific to the location of the existing PCP and thus to the properties in the immediate area it is considered that the new service will benefit the wider community as a whole.

Every effort has been made to accommodate this important piece of telecommunications equipment in order that visual intrusion is minimised and the impact upon road users and pedestrians is reduced. It is considered that the siting of the cabinet has been made using the optimum location taking into consideration both Town Planning and Highways requirements.

Contact Details

Name	William Osborne	Telephone	01634 661556
Applicant	Openreach	Fax no	
Address	Harlequin Group Innovation Centre Maidstone Road Chatham Kent. ME5 9FD	Email address	planning@harlequin- group.com

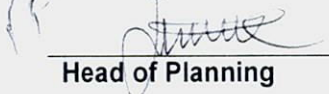Signed		Date	16.2.12
Position	Head of Planning	Company	Harlequin Group
		(on behalf of the applicant)	